

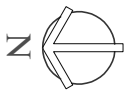


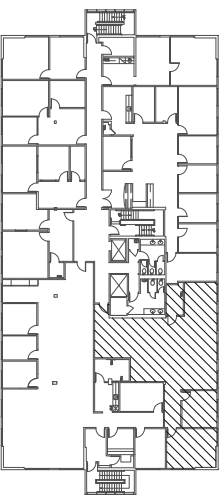

3838 Carson Street
Torrance, CA 90503

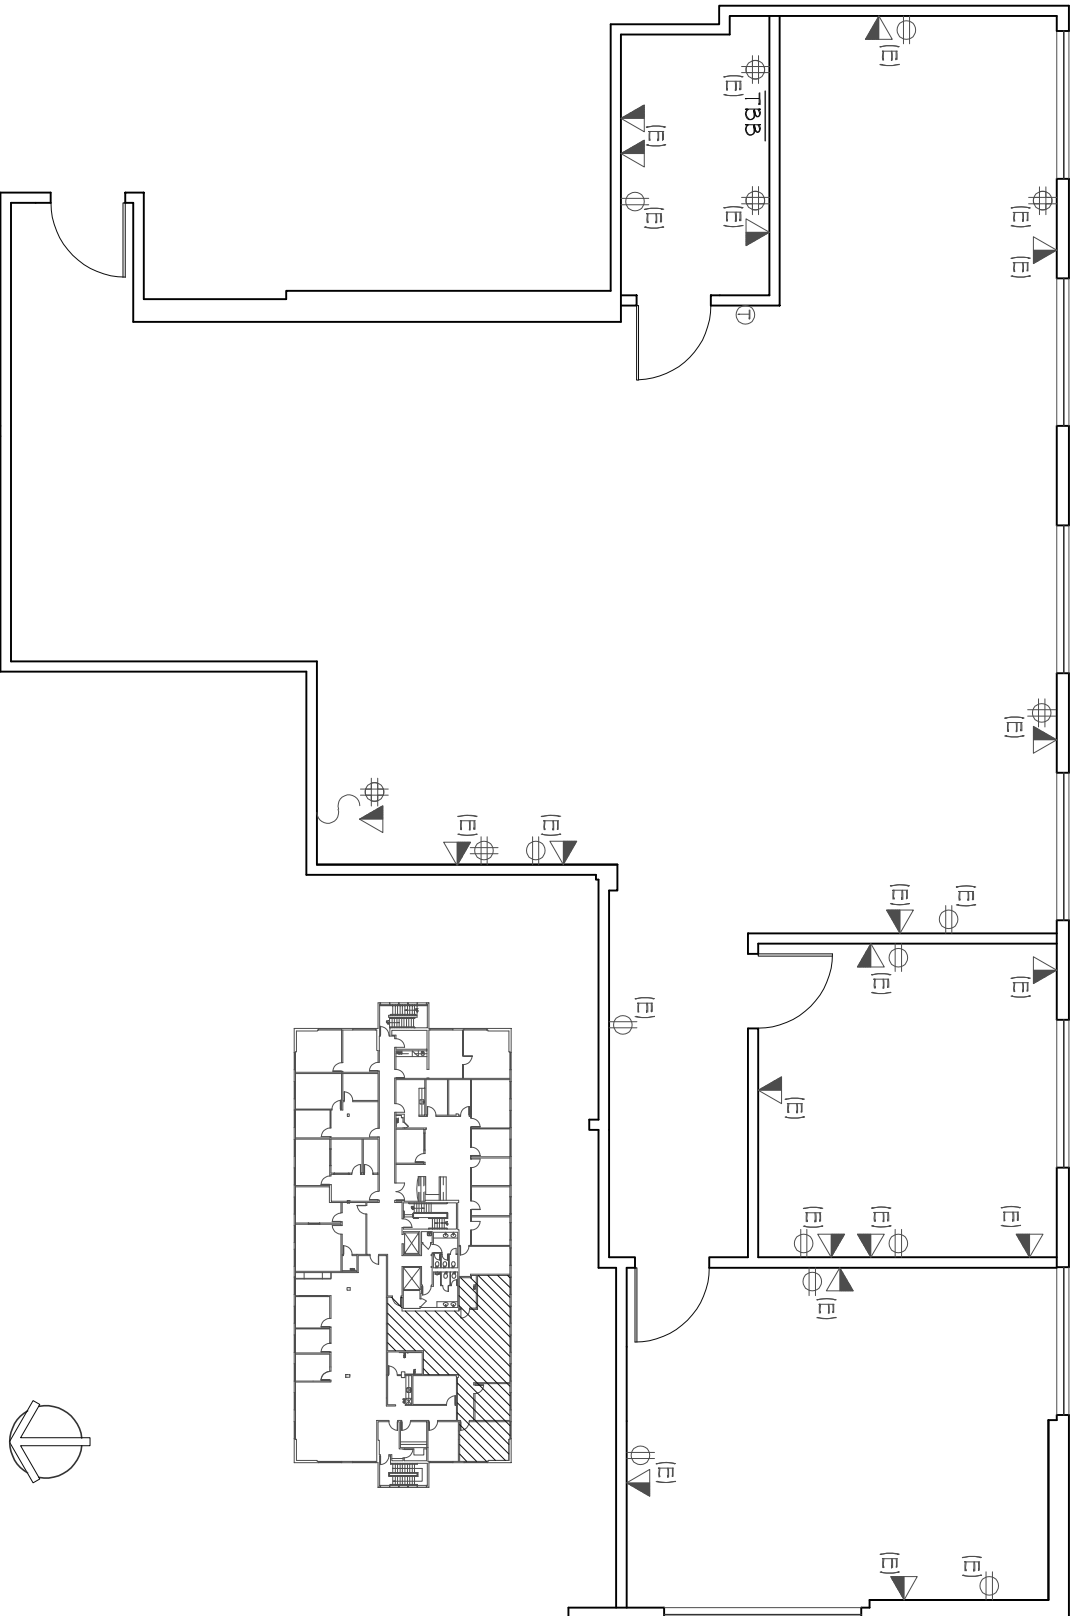

SUITE 210
SCALE: 1/8"=1'-0"
DATE: 11-4-20
1,928 RSF

TORRANCE EXECUTIVE PLAZA



TEL.: 310-316-4290, FAX: 310-543-2905

ERIC LASTTION
GEOFFERY LUDWIG
SHARENE SEHR
TEL.: 310.491.2000



Newmark Knight Frank

THE WREN GROUP
INCORPORATED
Planning & Interiors
626.564.2650

