


OFFICE FOR LEASE

3828-3878 CARSON STREET, TORRANCE



3848 Carson Street
Torrance, CA 90503

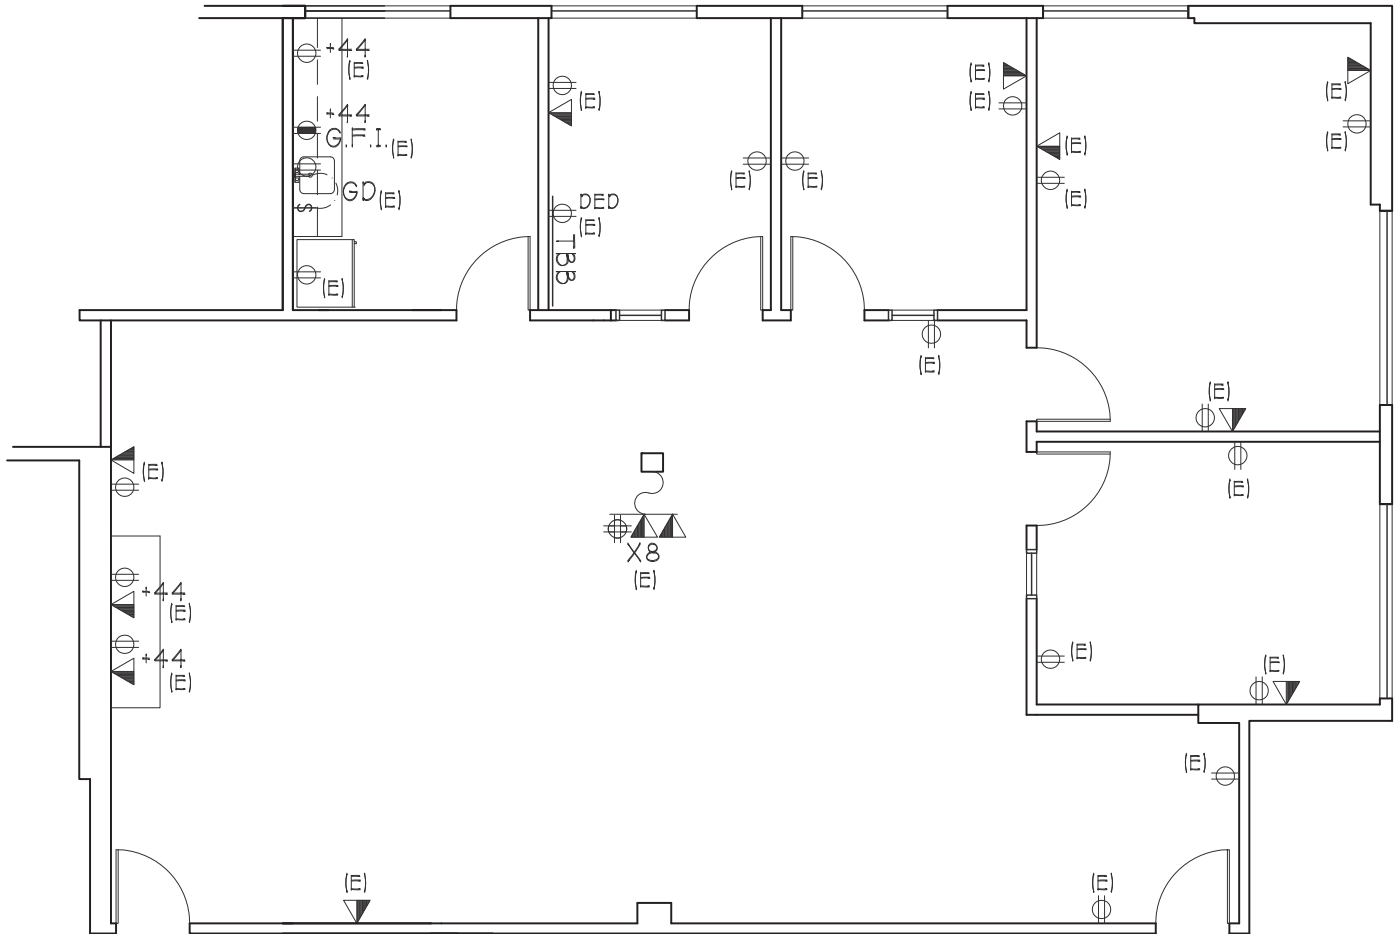

SUITE 200

SCALE: 1/8"=1'-0"

DATE: 11-02-17

2,171 RSF

The information contained herein has been obtained from sources deemed reliable but has not been verified and no guarantee, warranty or representation, either express or implied, is made with respect to such information. Terms of sale or lease and availability are subject to change or withdrawal without notice.