


OFFICE FOR LEASE

3828-3878 CARSON STREET, TORRANCE

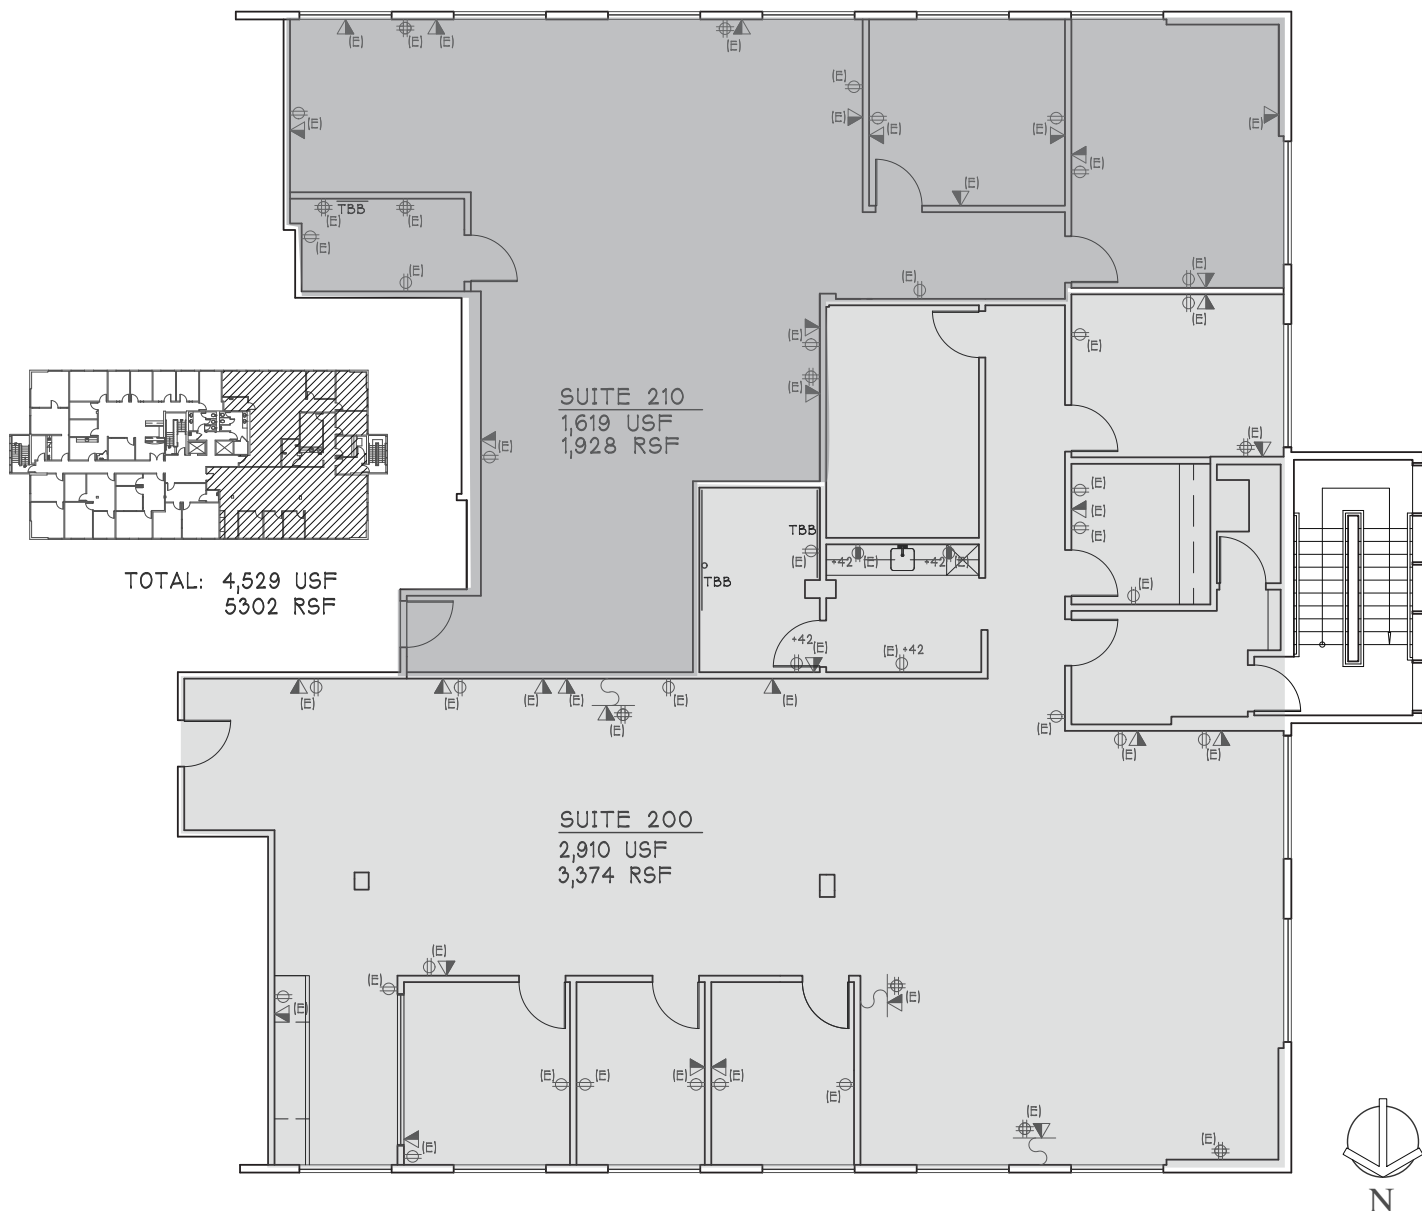

3838 Carson Street
Torrance, CA 90503

SUITE 200&210
SCALE: N.T.S.
DATE: 08-31-2020

The information contained herein has been obtained from sources deemed reliable but has not been verified and no guarantee, warranty or representation, either express or implied, is made with respect to such information. Terms of sale or lease and availability are subject to change or withdrawal without notice.