



TORRANCE EXECUTIVE PLAZA

the Muller company

TEL.: 310-316-4290, FAX: 310-543-2905




Newmark Knight Frank

ERIC LASTITION
GEOFFERY LUDWIG
TEL.: 310.491.2000



THE WREN GROUP
INCORPORATED
Planning & Interiors
626.564.2650

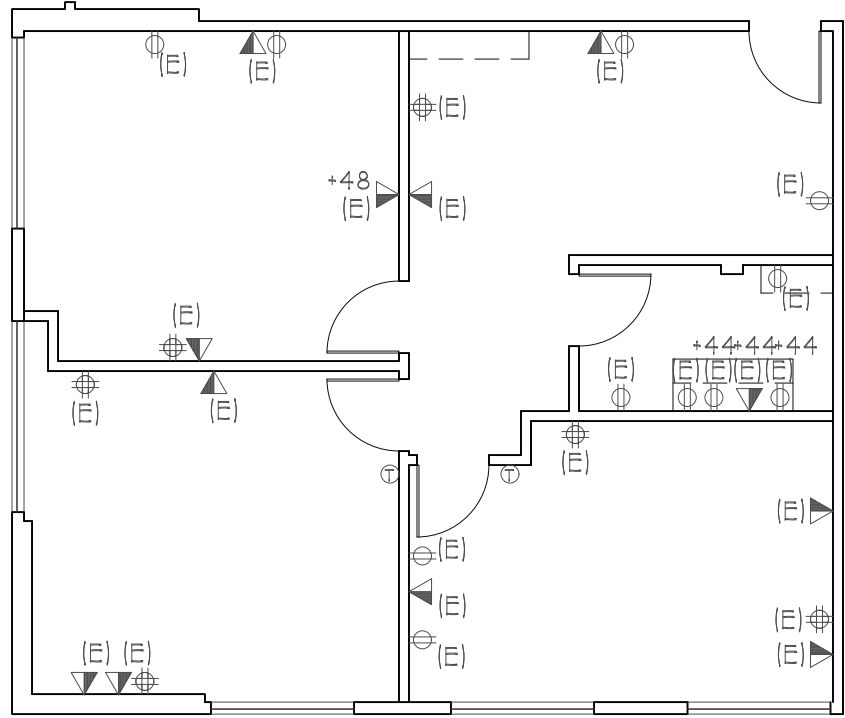

SUITE 100
SCALE: 1/8"=1'-0"
DATE: 09-04-19
1,131 RSF



3868 Carson Street
Torrance, CA 90503