


# OFFICE FOR LEASE

3828-3878 CARSON STREET, TORRANCE

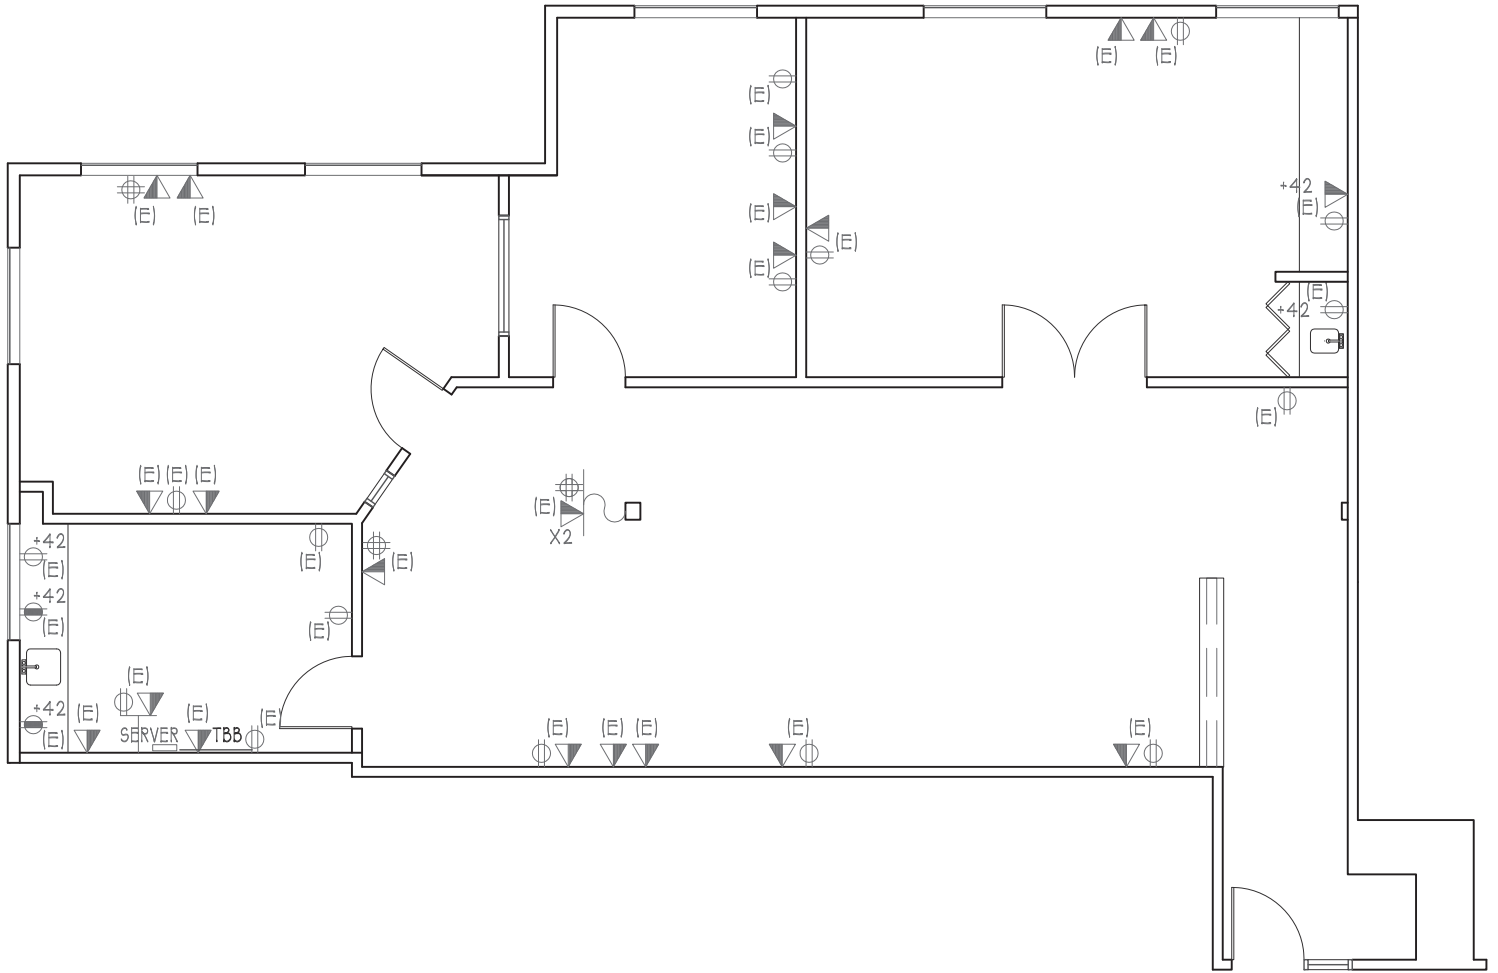

**3858 Carson Street**  
Torrance, CA 90503

**SUITE 304**  
SCALE: 1/8"=1'-0"  
DATE: 06-20-18  
1,910 RSF

The information contained herein has been obtained from sources deemed reliable but has not been verified and no guarantee, warranty or representation, either express or implied, is made with respect to such information. Terms of sale or lease and availability are subject to change or withdrawal without notice.